
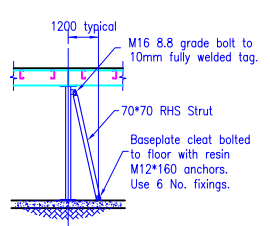


BEAM SECTIONS	COLUMN & BASEPLATE SECTIONS	STABILITY BRACING
Bm01 254x102x22	Col01 070x70x13	Sb01 070x70x13
Bm02 302x102x25	Col02 070x70x13	Sb02 070x70x13
Bm03 302x102x25	Col03 070x70x13	Sb03 070x70x13
Bm04 302x102x25	Col04 070x70x13	Sb04 070x70x13
Bm05 302x102x25	Col05 070x70x13	Sb05 070x70x13
Bm06 302x102x25	Col06 070x70x13	Sb06 070x70x13
Bm07 302x102x25	Col07 070x70x13	Sb07 070x70x13
Bm08 302x102x25	Col08 070x70x13	Sb08 070x70x13
Bm09 302x102x25	Col09 070x70x13	Sb09 070x70x13
Bm10 457x152x60	Col10 100x100x6	Sb10 100x100x6
Bm11 457x152x60	Col11 100x100x6	Sb11 100x100x6
Bm12 457x152x60	Col12 100x100x6	Sb12 100x100x6
Bm13 457x152x60	Col13 100x100x6	Sb13 100x100x6
Bm14 457x152x60	Col14 100x100x6	Sb14 100x100x6
Bm15 457x152x60	Col15 100x100x6	Sb15 100x100x6
Bm16 457x152x60	Col16 100x100x6	Sb16 100x100x6
Bm17 457x152x60	Col17 100x100x6	Sb17 100x100x6
Bm18 457x152x60	Col18 100x100x6	Sb18 100x100x6
Bm19 457x152x60	Col19 100x100x6	Sb19 100x100x6
Bm20 457x152x60	Col20 100x100x6	Sb20 100x100x6
Bm21 457x152x60	Col21 100x100x6	Sb21 100x100x6
Bm22 457x152x60	Col22 100x100x6	Sb22 100x100x6
Bm23 457x152x60	Col23 100x100x6	Sb23 100x100x6
Bm24 457x152x60	Col24 100x100x6	Sb24 100x100x6
Bm25 457x152x60	Col25 100x100x6	Sb25 100x100x6
Bm26 302x102x25	Col26 070x70x13	Sb26 070x70x13
Bm27 302x102x25	Col27 070x70x13	Sb27 070x70x13
Bm28 302x102x25	Col28 070x70x13	Sb28 070x70x13
Bm100 302x102x25	Col100 070x70x13	Sb100 070x70x13

[315.58] Denotes an unfactored column load in KN

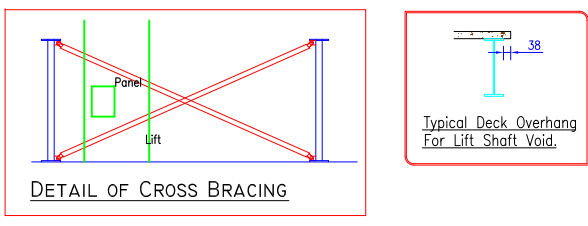

COLOUR SPECIFICATION

Column:	Graphite Grey RAL 7024
Beam:	Graphite Grey RAL 7024
Handrail Tube:	Blue RAL 5010
Handrail Post:	Blue RAL 5010
Kick Rail:	Blue RAL 5010
Stair Stringers:	Graphite Grey RAL 7024
Stair Treads:	Graphite Grey RAL 7024
Joist & Cleats:	Galvanised Finish
Landings:	Graphite Grey RAL 7024
Other:	Graphite Grey RAL 7024

SPECIFICATIONS FOR MEZZANINE FLOOR





LOADING: Live Load = 7.2kN/m²
Service Load = 0.18kN/m²
Dead Load = 0.35kN/m²

JOISTS: BW30520 Joists @ 600 c/c
Note: Joist supplier/design to be confirmed

STAIRCASE: 100x50x4 RHS Stringers with 1200 wide Steel Treads.
50x25 RHS hand and knee rail both sides.

HANDRAIL: 50 Sq. RHS posts @ 1500 c/c with Powder coated hand and knee rail.

KICKRAIL: 100mm high flat sided oval.

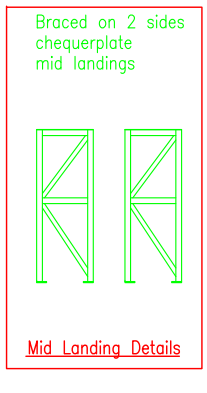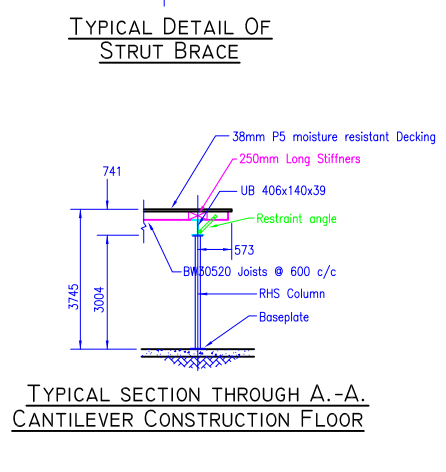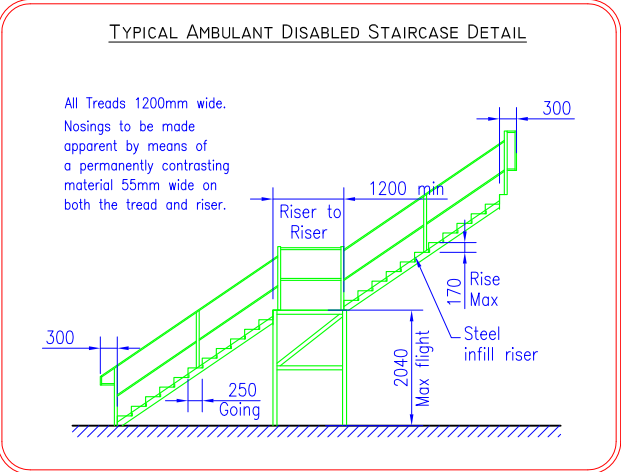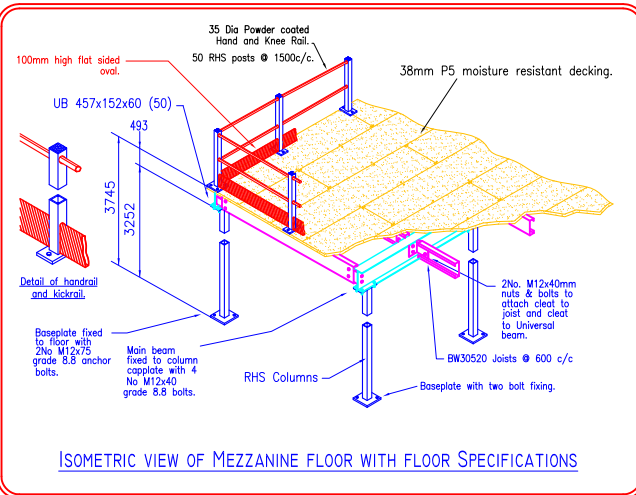

KEY

	Column and baseplate
	Edge protection
	Primary Beams
	Secondary Joists
	70x70x3.0 RHS/
	150x80x8 Base Plate

Note: COLUMNS NOT DESIGNED FOR ACCIDENTAL IMPACT. SUITABLY DESIGNED COLUMN PROTECTORS SHOULD BE SUPPLIED AND INSTALLED BY OTHERS AFTER MEZZANINE COMPLETION IF FORKLIFT USAGE IS INTENDED IN OR AROUND THE MEZZANINE AREA

GEM DISTRIBUTION LTD
Shorten Brook Drive
Daleside Road
Altham Business Park
Accrington
Lancs
BB5 5YH

rda PROJECTS

Innovation House
Daleside Road
Nottingham
NG2 4DH

Tel 0115 9110243
Fax 0115 9110246

DRAWN BY: SG	DATE DRAWN: 19/03/08	SCALE: A1 SHEET 1:100	PROJECT NUMBER: P10529DP /1c
DRAWING APPROVAL	PRINT YOUR NAME: AS BUILT	APPROVAL DATE	
SIGN YOUR NAME:			